



360 Portage Ave (17) • Winnipeg Manitoba Canada • R3C 0G8  
Telephone / N° de téléphone : 204-360-4773 • Fax / N° de télécopieur : 204-360-6138  
dbowen@hydro.mb.ca

---

2018 10 09

Siobhan Burland Ross  
A/Director - Environmental Approvals Branch  
Manitoba Sustainable Development  
1007 Century Street  
Winnipeg, MB R3H 0W4

Dear Ms. Burland Ross:

**RE: KEYASK GENERATION PROJECT – NOTICE OF ALTERATION, SHORT TERM RELEASE OF SEEPAGE WATER WITH ELEVATED TSS AT THE SOUTH DAM COFFERDAM ENVIRONMENT ACT LICENCE NO. 3107, CLIENT FILE 5550.00**

Manitoba Hydro, in its delegated authority to manage construction of the Keeyask Generation Project on behalf of the Keeyask Hydropower Limited Partnership, is submitting a notice of alteration to Environment Act Licence (EAL) No. 3107 to temporarily release seepage water from the South Dam Cofferdam (SDCD) directly to the Nelson River, when the end-of-pipe Total Suspended Solids (TSS) concentration is greater than 50 mg/L. The duration of this request is until repairs to the upstream South Dam Cofferdam have been completed, which are anticipated to be completed by the middle of November 2018.

Dewatering of the South Dam Cofferdams started on September 16, 2018. After the fish rescue was completed on September 26, it became apparent that the foundation of the upstream SDCD was experiencing seepage at a rate higher than designed. This appears to be attributed to unforeseen geological conditions and/or alluvial deposits along the river bed.

The seepage is currently being managed with diesel pumps but will be difficult to maintain in the winter months and during construction of the South Dam. Steps are being taken to reduce the flows. A repair option was developed and should be executed before continuous freezing conditions occur. Based on past experience, it is likely that the end of pipe TSS concentration will increase above 50 mg/L during execution of cofferdam seepage repairs with short term spikes up to 1000 mg/L. To reduce the risk of schedule delays, a notice of alteration to EAL No. 3107 is being submitted to temporarily release impounded water from within the South Dam Cofferdams directly to the Nelson River in the Spillway Channel, even if TSS is greater than 50 mg/L.

Siobhan Burland Ross

2018 10 09

Page 2

Please refer to the attached description for details. If additional information is required, please contact Jodine MacDuff at 204-360-5539.

Yours truly,

A handwritten signature in blue ink that reads "Dave Bowen". The signature is fluid and cursive, with a long horizontal stroke extending to the right.

Dave Bowen, P. Eng, M.Sc  
Director, Keeyask Project  
Generation & Wholesale

Att.



**Keeyask Generation Project**  
**Notice of Alteration - Environment Act Licence No. 3107**  
**Short Term Release of Seepage Water with Elevated Total Suspended Solids at the South Dam**  
**Cofferdam**

Manitoba Hydro, in its delegated authority to manage construction of the Keeyask Generation Project on behalf of the Keeyask Hydropower Limited Partnership, is requesting an alteration to Environment Act Licence (EAL) No. 3107 to temporarily release seepage water from the South Dam Cofferdam (SDCD) directly to the Nelson River, when the end-of-pipe Total Suspended Solids (TSS) concentration is greater than 50 mg/L. The duration of this request is until repairs to the upstream South Dam Cofferdam have been completed, which are anticipated to be completed by the middle of November 2018.

**Background**

The Keeyask Generation Project Environmental Protection Plan (EnvPP), section 7.21.2 #5, states:

*Impounded water will be tested for total suspended solids (TSS) before release. If TSS concentration is < 25 mg/L, the water can be released directly to the Nelson River. If the water does not meet these criteria, it will be treated prior to release.*

In July 2017, approval was received to add the following clause to the EnvPP:

*At designated discharge locations, as shown in Figures 1 and 2, impounded water with total suspended solids (TSS) concentration up to 50 mg/L can be discharged directly to the Nelson River. When TSS concentrations exceed 25 mg/L, water discharge volumes along with corresponding TSS concentrations will be recorded and included in the annual Environmental Protection Plan report.*

The Keeyask Generation Project South Dam will be located in the south channel of the Nelson River, Figure 1 and construction will occur in the summer of 2019. To prepare for this, excavation; surface/foundation preparations and installation of the grout curtain will occur in the fall/winter of 2018/2019 and must be conducted in the dry; therefore, the South Dam cofferdam needs to have a well-managed seepage plan.

Dewatering of the South Dam Cofferdams started on September 16. After the fish rescue was completed on September 26, it became apparent that the foundation of the upstream SDCD was experiencing seepage at a rate higher than designed at approximately 500 L/s (0.5 cms or 8,000 USgpm). This appears to be attributed to unforeseen geological conditions and/or alluvial deposits along the river bed. Although a cleaning operation was completed on the toe of the upstream SDCD to remove alluvial deposits on the river bed, it appears there is a bedrock low which was beyond the reach of the

equipment used for cleaning.

The seepage is currently being managed with diesel pumps but will be difficult to maintain in the winter months and during construction of the South Dam, therefore steps are being taken to reduce the flows. As well, removal of unclassified material within the footprint of the upstream and downstream SDCDs would increase the seepage rate to levels that could become unmanageable. A repair option has been developed for the northwest corner of the upstream SDCD and should be executed before continuous freezing conditions occur. During the first week of October 2018, the day temperatures at the Keeyask site have been below 5°C and overnight temperatures have been between -5 to 0°C.

Based on past experience, it is likely that the end of pipe TSS concentration will increase above 50 mg/L during execution of cofferdam seepage repairs with short term spikes up to 1000 mg/L. At the current seepage rates it is not feasible or practical to pump or transport the water by truck to the settling pond. Diverting this water to settling ponds for treatment would require running heated lines across the currently flowing spillway for a distance of 3.0 km to an existing settling pond north of the tailrace channel or running a heated line for a distance of at least 3.7 km south to the borrow site S2a. Therefore to meet the TSS concentration limits as stated in the EnvPP, pumping of the seepage water would need to be suspended until sediments settle. This could result in flooding of the South Dam footprint which would delay the South Dam foundation excavation and curtain grouting activities. There is also a risk that if pumping of seepage water is stopped due to high TSS levels that the downstream SDCD would be overtopped. The crest of the downstream SDCD is at elevation 145.6 m, the crest of the upstream SDCD is 152.2 m and current upstream water level is approximately 148 m. With the upstream water level approximately 2.4 m above the crest of the downstream SDCD the risk of uncontrolled overtopping of the cofferdam exists and needs to be avoided. A delay due to flooding in the South Dam channel would jeopardize activities scheduled for both the winter of 2018/2019 and summer of 2019.

To reduce the risk of schedule delays, an alteration to EAL No. 3107 is requested to temporarily release impounded water from within the South Dam Cofferdams directly to the Nelson River in the Spillway Channel, even if TSS is greater than 50 mg/L.

### **Description of Construction of South Dam Cofferdam Repair**

Construction activities to decrease the seepage of the upstream SDCD includes constructing a rock groin upstream of the current upstream SDCD, widening the existing key-in to the Spillway Cofferdam and placing additional impervious material between the existing upstream SDCD and the proposed rock groin, Figures 2a and 2b. All this work will be within the footprint identified in the Notice of Alteration to Environment Act Licence which was approved on August 9, 2018.

### **Potential Environmental Effects**

Repairs to the upstream SDCD will involve the placement of impervious material (clayey silt – Class A)

which will be sourced from one of the current borrow sources, most likely from S2a located 3.5 km south of this site, Figure 3. Currently, cofferdam seepage water is “clean” and the TSS concentration is similar to the levels in the Nelson River. During the repair, it is anticipated that the material that is being placed will be suspended in the seepage water. Based on past experience, it is likely that the end of pipe TSS concentration will increase above 50 mg/L during execution of cofferdam seepage repairs with short term spikes up to 1000 mg/L. It is proposed to discharge this water directly to the Nelson River in the Spillway channel.

To determine potential effects of discharging water with elevated TSS, sediment plume modeling was conducted with a TSS concentration of 2,000 mg/L at a rate of 600 L/s (9,500 USgpm), which produces a sediment loading rate of 1.2 kg/s. Previous analyses investigated the same loading rate at the spillway for a flow of 3,500 cms in the Nelson River. The modeled sediment plume (Figure 4) showed in stream TSS increases of >5 mg/L were confined to a highly localized area at the point of discharge while the plume of TSS increase from 1-5 mg/L did not extend beyond the end of the discharge channel. Although the current river flow of about 2,700 cms is lower than the 3,500 cms used in the model, it can be expected that TSS increases >5 mg/L would similarly remain confined to a highly localized area near the point of discharge due to rapid mixing in the turbulent flow of the discharge channel. The area with TSS increases of 1-5 mg/L would likely affect a similarly narrow part of the flow but extending somewhat further downstream within the area of high flow velocities and turbulent conditions. River flows were projected to increase to about 3,300 cms (50th percentile estimate) by mid-November, bringing flow conditions closer to those represented in Figure 4.

Based on the models, the increase in TSS concentration will not be greater than 5 mg/L above background downstream of the Spillway Discharge Channel. Releasing seepage water with elevated TSS in the Spillway channel is expected to have negligible effects to fish.

### **Monitoring and Reporting**

Monitoring TSS will continue to be performed by Manitoba Hydro Environmental Inspectors and the Contractor’s environmental and water management team. A summary of the volume of water pumped and the TSS concentrations will be submitted to the Environment Officer, Environmental Approvals Branch once the repairs are complete.

The sampling location is at the pump station, these are sampled at least twice per day. Real-time monitoring of TSS cannot occur, therefore the relationship between turbidity and TSS that is provided in the *Sediment Management Plan for In-stream Construction* will be utilized which is:

$$\text{TSS (mg/L)} = 0.79 \text{ Tu (NTU)} - 2.86$$

It should be noted that the SMP stations have been removed for the shoulder season, therefore monitoring SMP downstream at SMP 2 and 3 will not be possible.

## **Summary of Potential Effects**

Model results for a moderate river flow showed that the sediment load from dewatering has a negligible, highly localized effect on in-stream TSS even if the end-of-pipe limit is increased to 2000 mg/L. The source of the sediment load will be from raw impervious material that is sourced within the project site. The effects on downstream sedimentation would not be measurable.




<b>DATA SOURCE:</b> Manitoba Hydro; Government of Manitoba; Government of Canada; Image Source: ESA Sentinel 2 Satellite; August 19th, 2018		
<b>CREATED BY:</b> Manitoba Hydro - GIS Studies		
<b>COORDINATE SYSTEM:</b> UTM NAD 1983 Z15N	<b>DATE CREATED:</b> 05-OCT-18	<b>REVISION DATE:</b>
	<b>VERSION NO:</b> 1.0	<b>QA/QC:</b>

<b>Legend</b> <b>Active Construction Areas</b> Cofferdam Haul & Site Road
--


**Keeyask Construction Area**

**Figure 1**



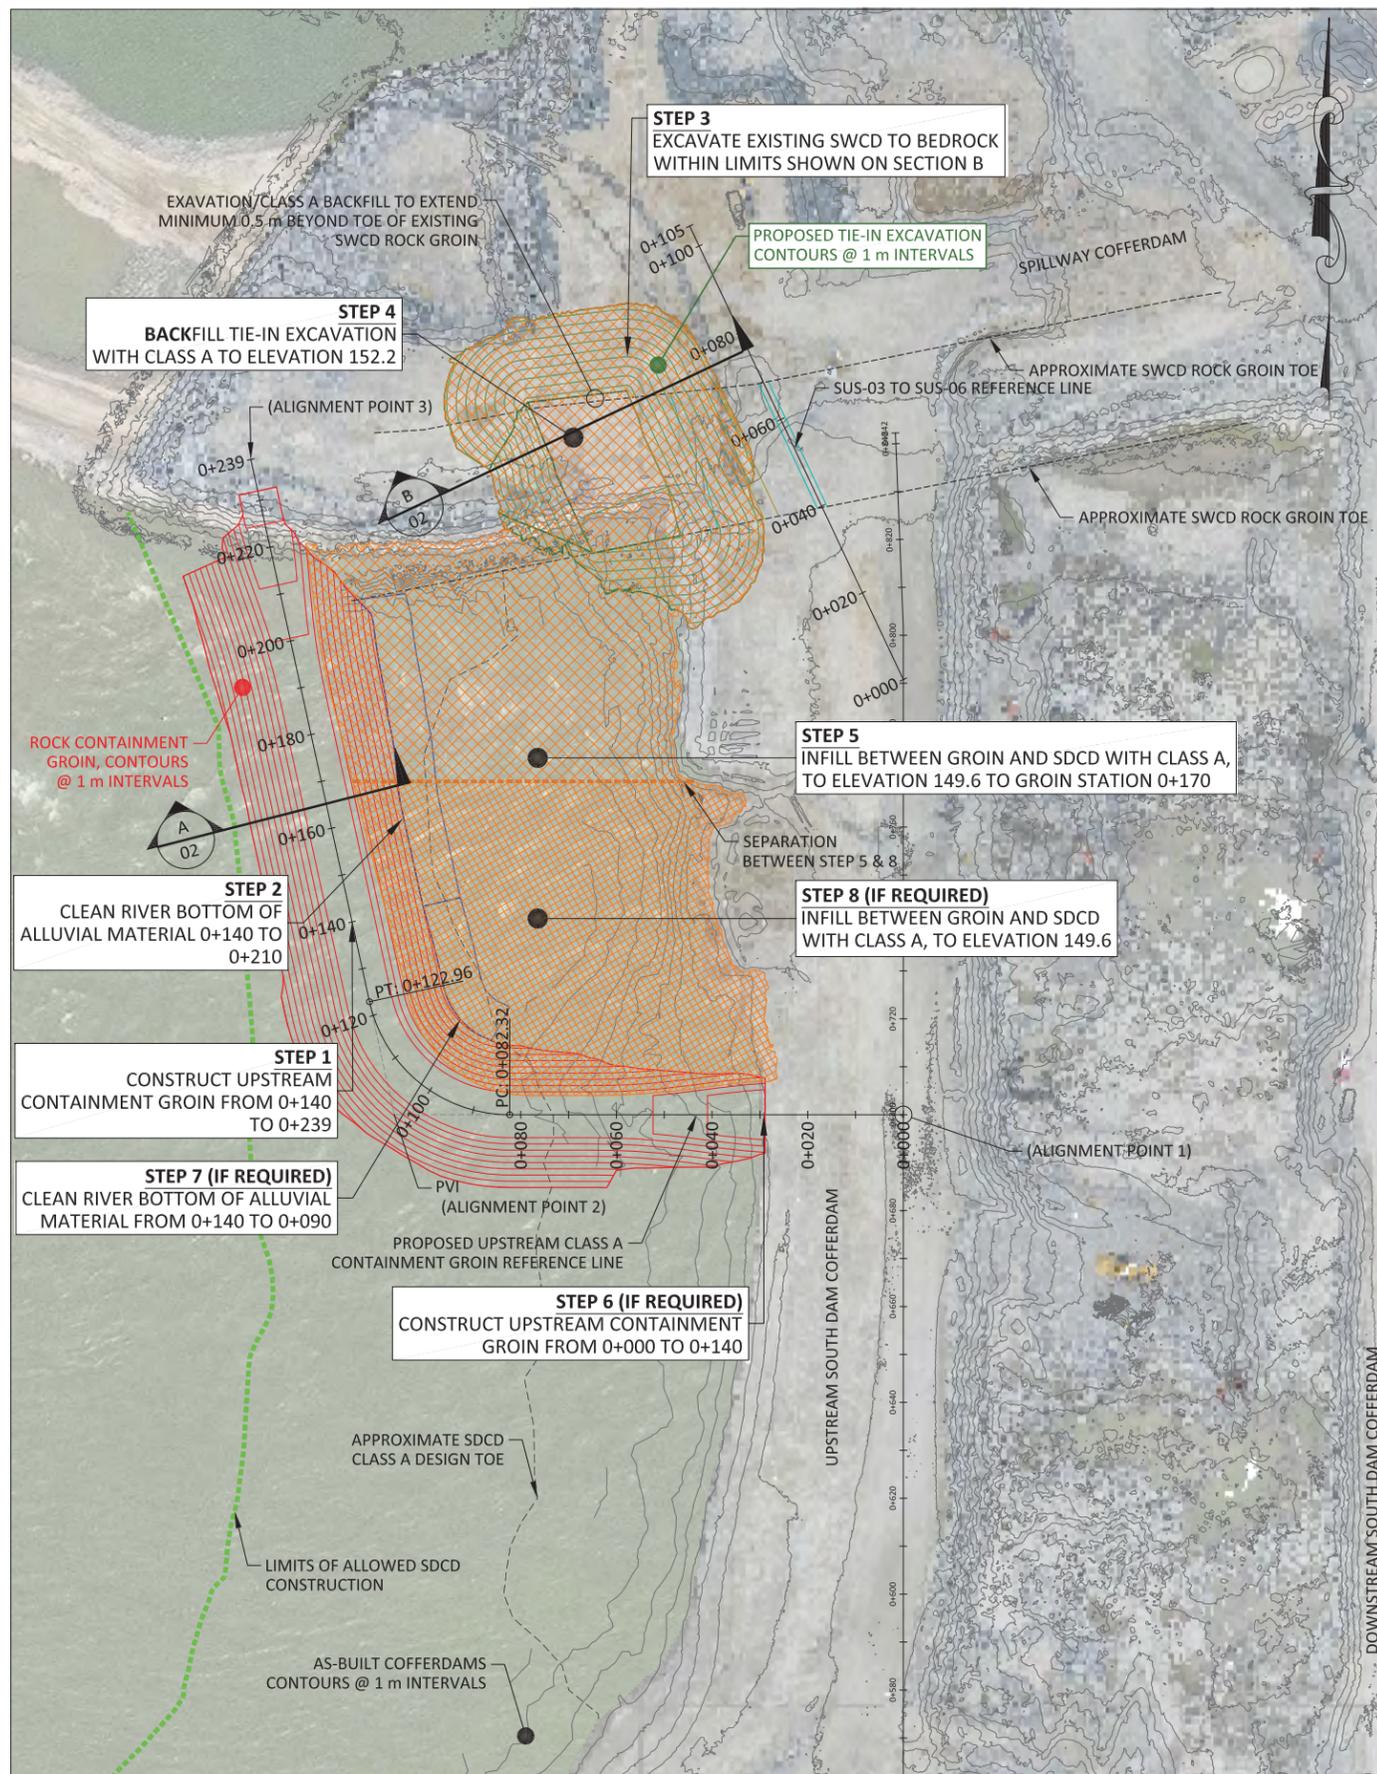

**PLAN**  
SCALE: 1:500

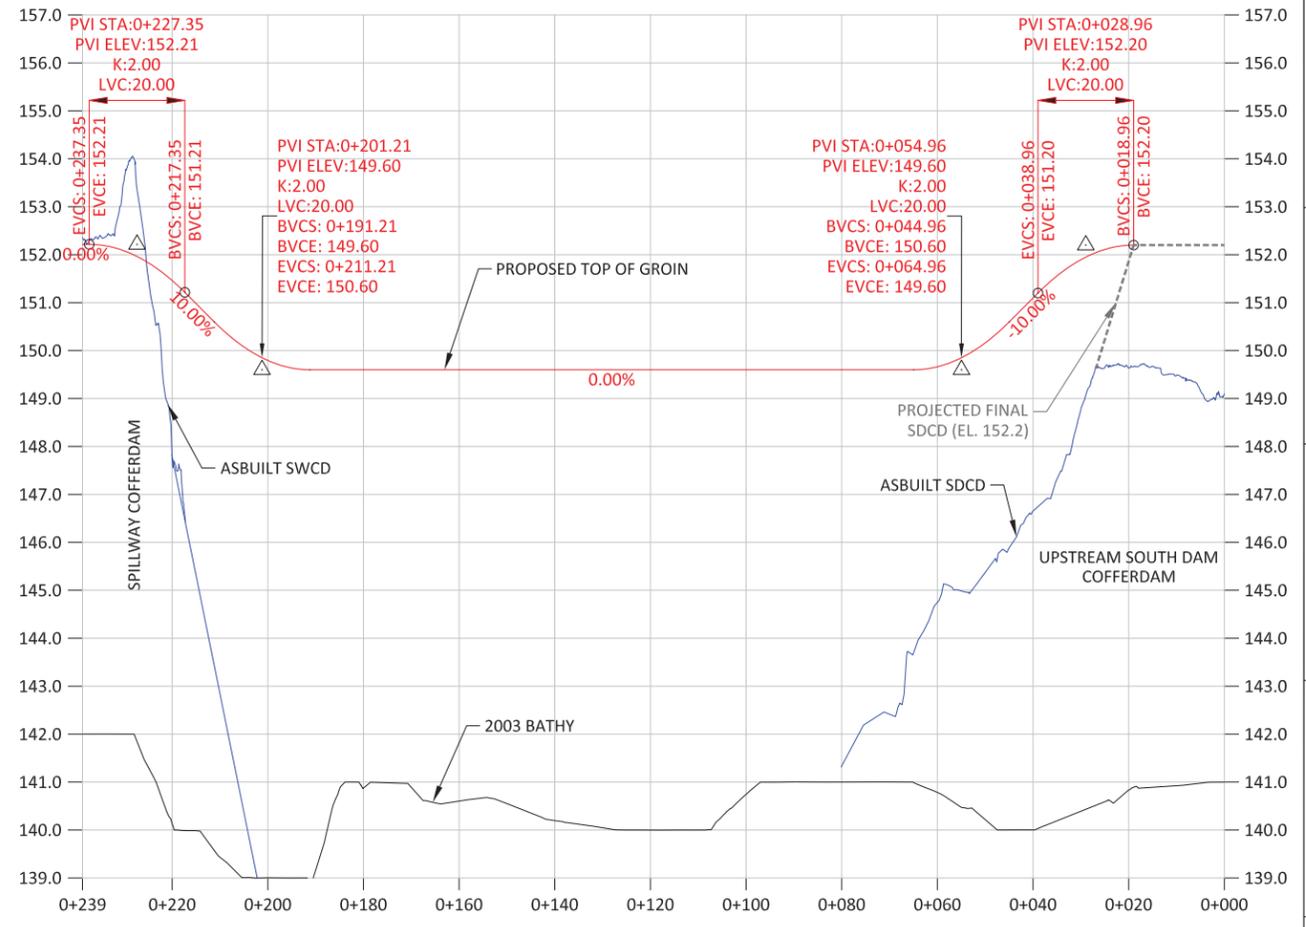

**PROFILE**  
SCALE: 1:500  
CLASS A CONTAINMENT GROIN

STAGING VOLUMES				
STEP #	DESCRIPTION	EXCAVATION cu.m	ROCKFILL cu.m	CLASS A cu.m
STEP 1	CONSTRUCT PARTIAL ROCK GROIN	-	15641	-
STEP 2	CLEAN DS RIVER BOTTOM FROM PARTIAL CONTAINMENT GROIN	-	-	-
STEP 3	EXCAVATE SWCD FOR TIE-IN	14465	-	-
STEP 4	FILL TIE-IN EXCAVATION WITH CLASS A	-	-	14465
STEP 5	PARTIAL INFILL BETWEEN CONTAINMENT GROIN AND SDCD	-	-	23432
STEP 6	CONSTRUCT REMAINING CONTAINMENT GROIN	-	15276	-
STEP 7	CLEAN DS RIVER BOTTOM FROM PARTIAL ROCK GROIN	-	-	-
STEP 8	INFILL REMAINING AREA BETWEEN CONTAINMENT GROIN AND SDCD	-	-	27514
<b>TOTALS</b>		<b>14465</b>	<b>30917</b>	<b>65411</b>

**CONTAINMENT GROIN ALIGNMENT COORDINATES**

- 1 - START (0+000): 48134.51, 19258.64
- 2 - PVI (RADIUS 30m): 48134.51, 19152.19
- 3 - END (0+239): 48271.18, 19122.20

**SWCD EXCAVATION TOE COORDINATES**

- NW TOE: 48283.11, 19180.13
- NE TOE: 48285.51, 19200.81
- SE TOE: 48255.28, 19211.98
- SW TOE: 48251.67, 19193.73

**NOTES**

- THE TIE-IN EXCAVATION SHALL BE BACKFILLED WITH MATERIALS APPROVED BY THE ENGINEER TO ENSURE CONTINUITY OF THE IMPERVIOUS MATERIALS BETWEEN THE SOUTH DAM COFFERDAMS, SPILLWAY COFFERDAM AND THE UPSTREAM SADDLE DAM.
- EXCAVATION INTO THE EXISTING SDCD CLASS A SHALL BE AT MINIMUM ANGLE TO PREVENT SLUMPING
- ADDITIONAL CLASS A SHALL BE PLACED ON THE SDCD TO PROVIDE A CONSISTENT SEAL TO EL. 152.20


**DRAWING NOTES:**

- DIMENSIONS AND ELEVATIONS ARE IN METERS
- ELEVATION ARE BASED ON CGVD28, 1929 ADJUSTMENT
- TOPOGRAPHIC INFORMATION BASED ON MANITOBA HYDRO & BBE ASBUILT SURVEY DATA FROM 2018
- BACKGROUND AERIAL DATED STITCHED TOGETHER FROM JUNE 2018 AERIAL AND SEPTEMBER 27 DRONE DATA


REV.	DATE	DESCRIPTION	BY	CHKD.	APP.
1	2018-10-05	DESIGNED: MH / HATCH	TJANSEEUW	AS NOTED	

**Manitoba Hydro**  
 AUTHENTICATION FOR CURRENT REVISION  
**KEYASK GENERATION PROJECT**  
**SOUTH DAM COFFERDAM**  
**UPSTREAM ALTERNATE TIE-IN & CONTAINMENT GROIN**  
**PLAN AND VOLUMES**  
 DRAWING NUMBER: **KS-432** SHEET: **01** REVISION: **00**

**Figure 2a**

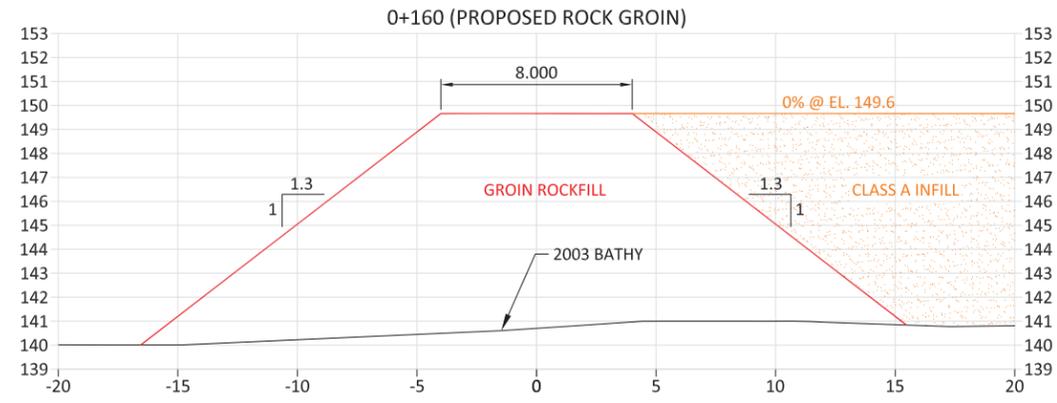

SECTION A  
SCALE: 1:100  
PROPOSED ROCK GROIN



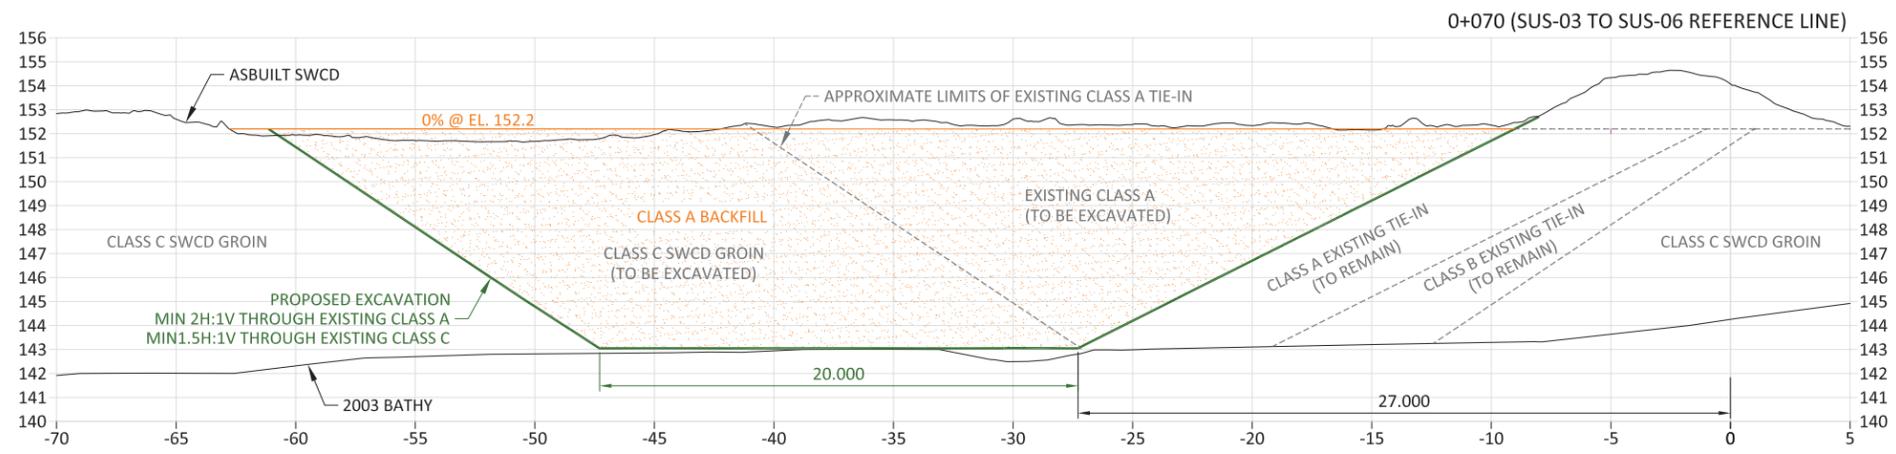


SECTION B  
SCALE: 1:100  
PROPOSED SWCD TIE-IN

- DRAWING NOTES:**
1. DIMENSIONS AND ELEVATIONS ARE IN METERS
  2. ELEVATION ARE BASED ON CGVD28, 1929 ADJUSTMENT
  3. TOPOGRAPHIC INFORMATION BASED ON MANITOBA HYDRO & BBE ASBUILT SURVEY DATA FROM 2018

REV.	DATE	DESCRIPTION	BY	CHKD.	APP.
		DRAWN: B.POSTLETHWAITE DESIGNED: MH / HATCH		CHECKED: T.JANSEEUW	SCALE: AS NOTED
<b>KEYASK GENERATION PROJECT</b> <b>SOUTH DAM COFFERDAM</b> <b>UPSTREAM ALTERNATE TIE-IN &amp; CONTAINMENT GROIN SECTIONS</b>					
DRAWING NUMBER		SHEET		REVISION	
KS-432		02		00	

Figure 2b

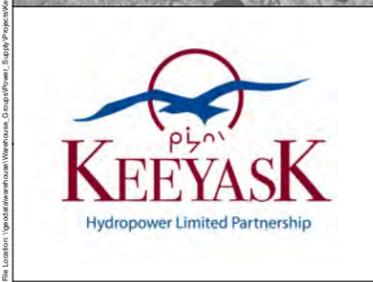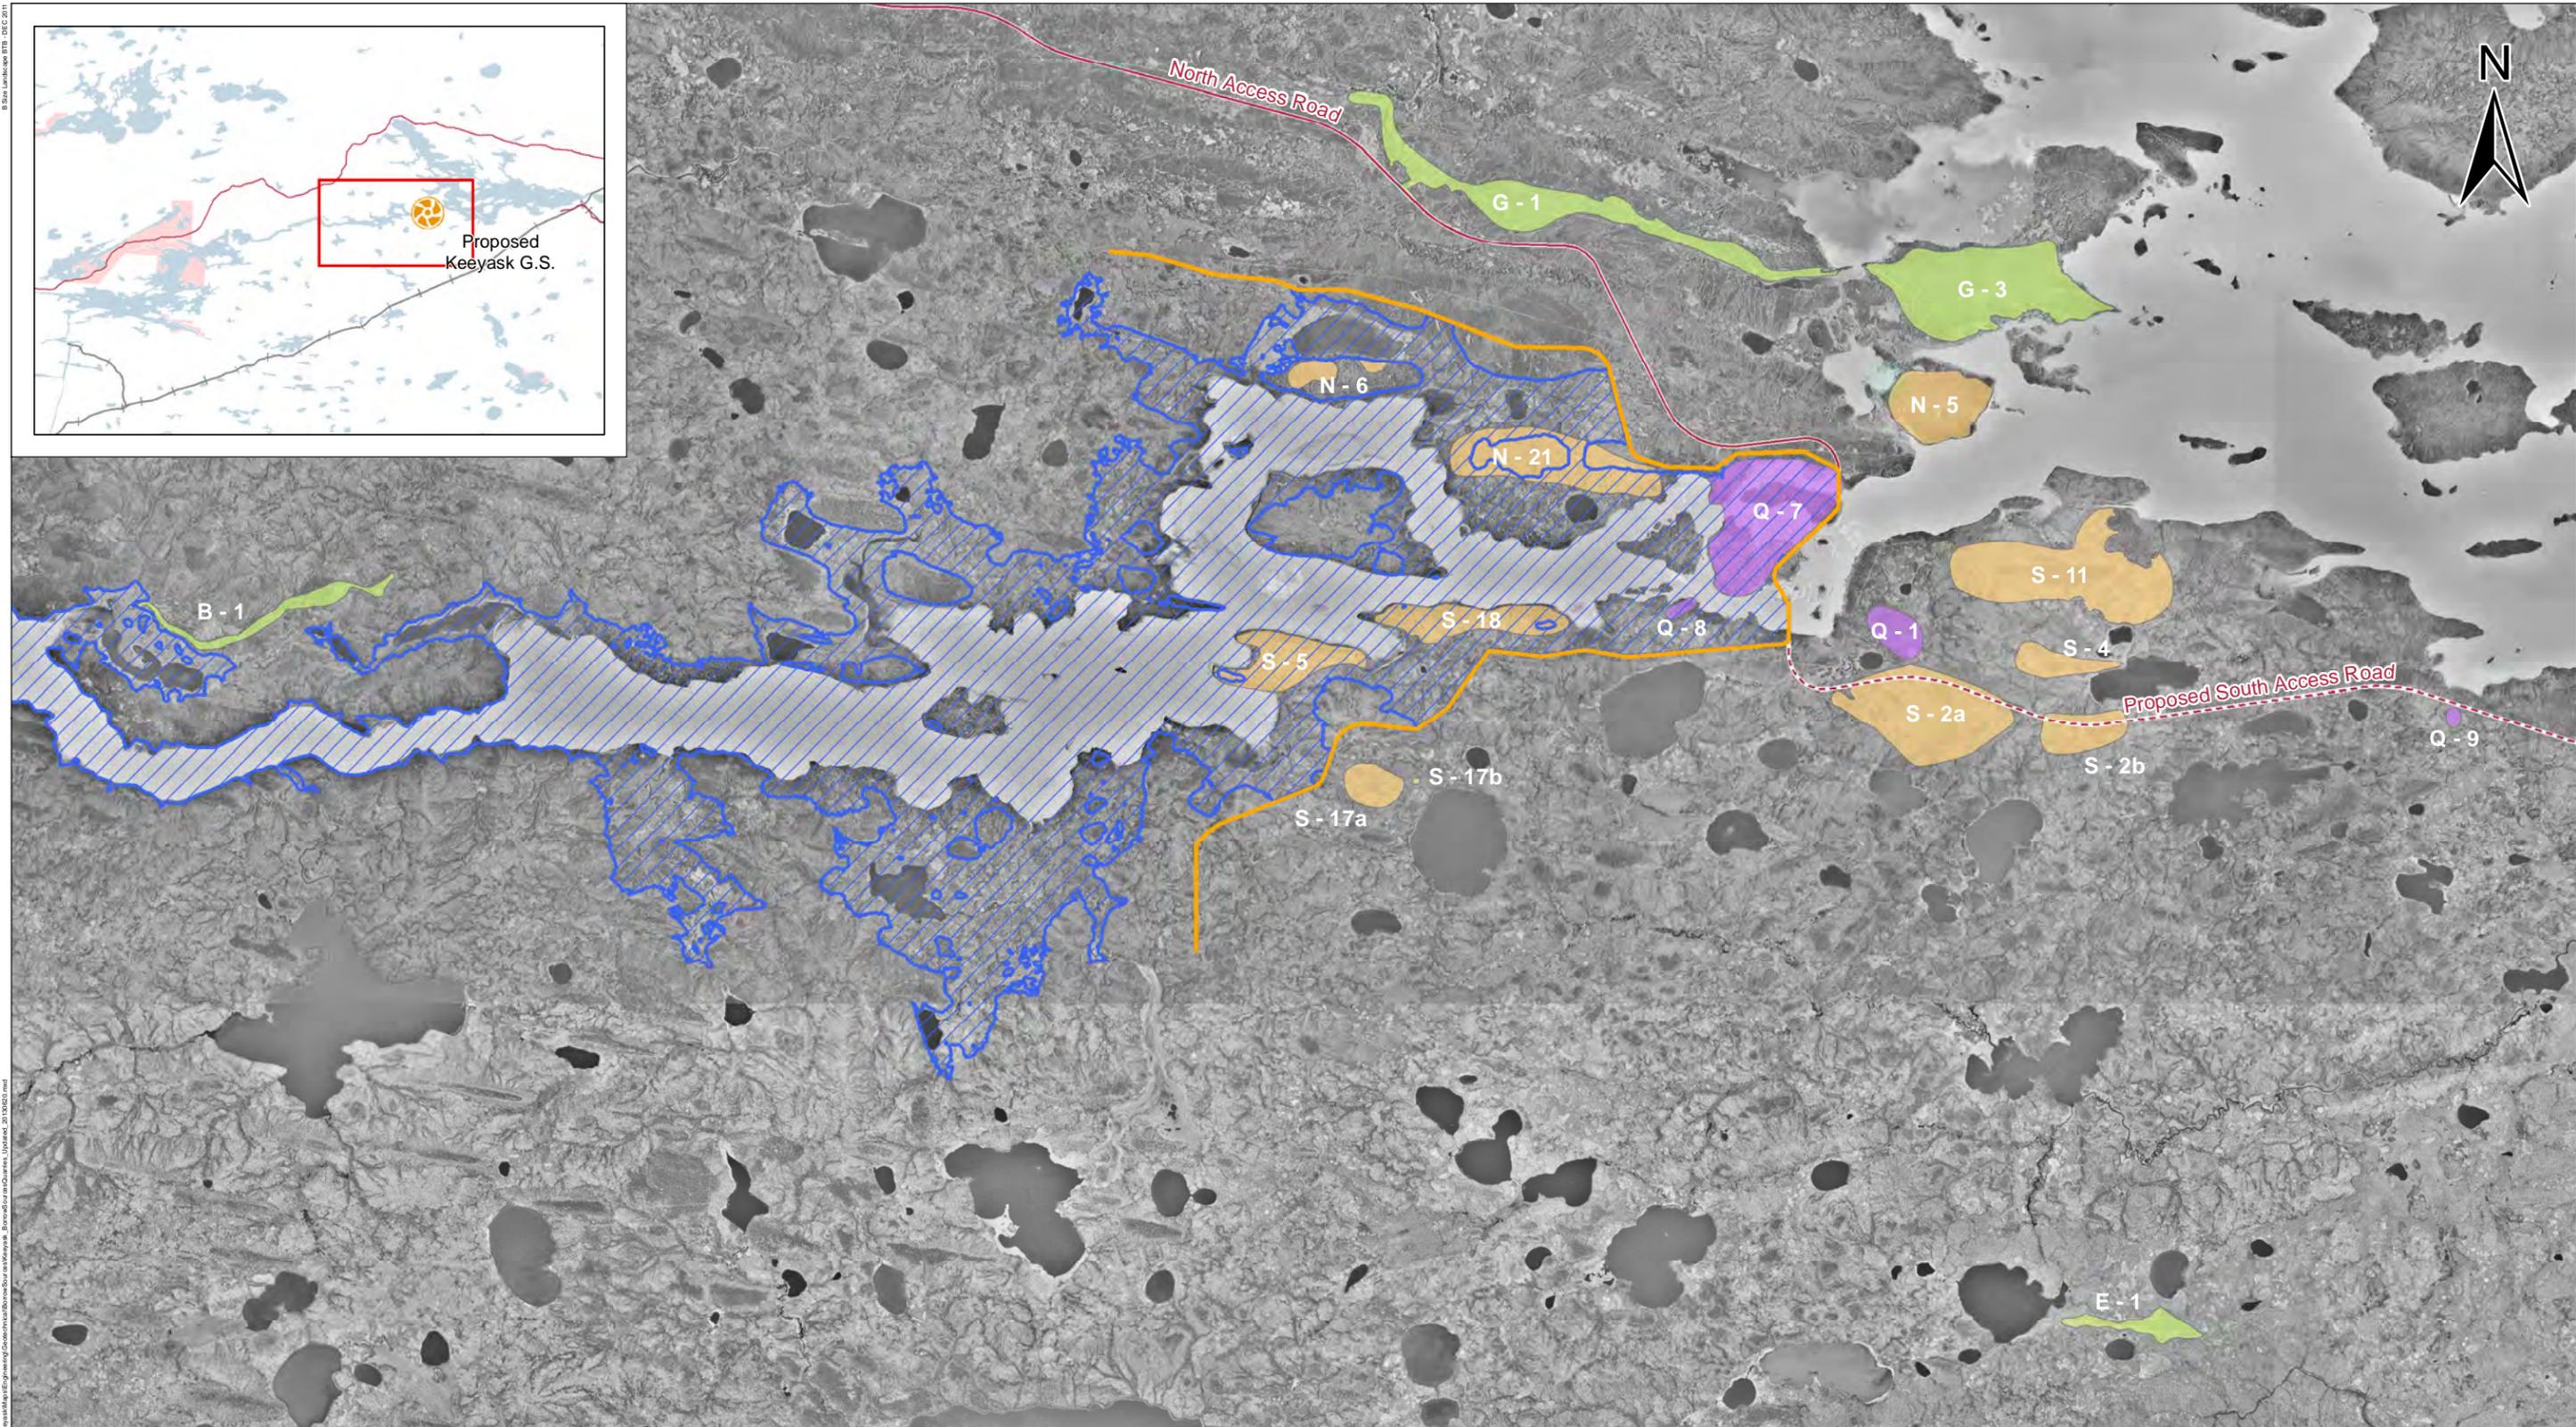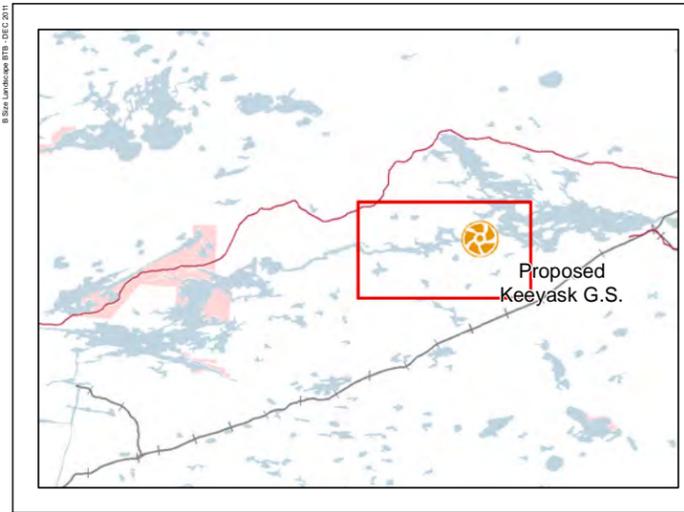

<b>DATA SOURCE:</b> Manitoba Hydro; Government of Manitoba; Government of Canada; KGS Acres; Manitoba Hydro 1999 1m Black & White DOI		
<b>CREATED BY:</b> Manitoba Hydro - Hydro Power Planning - GIS & Special Studies		
<b>COORDINATE SYSTEM:</b> UTM NAD 1983 Z15N	<b>DATE CREATED:</b> 09-FEB-12	<b>REVISION DATE:</b> 20-JUN-13
	<b>VERSION NO.:</b> 3.0	<b>QA/QC:</b> JCL/MES/ZZZ

Legend	
<b>Material Sources</b>	Access Road
Granular Borrow	Proposed Access Road
Impervious Borrow	Keeyask Principal Structures
Rock Quarry	Initial Flooded Area (159 m)

**Revised Keeyask Borrow Sources and Quarries**

**Figure 3**

